NEW BOOSTER STATION IS OPERATIONAL

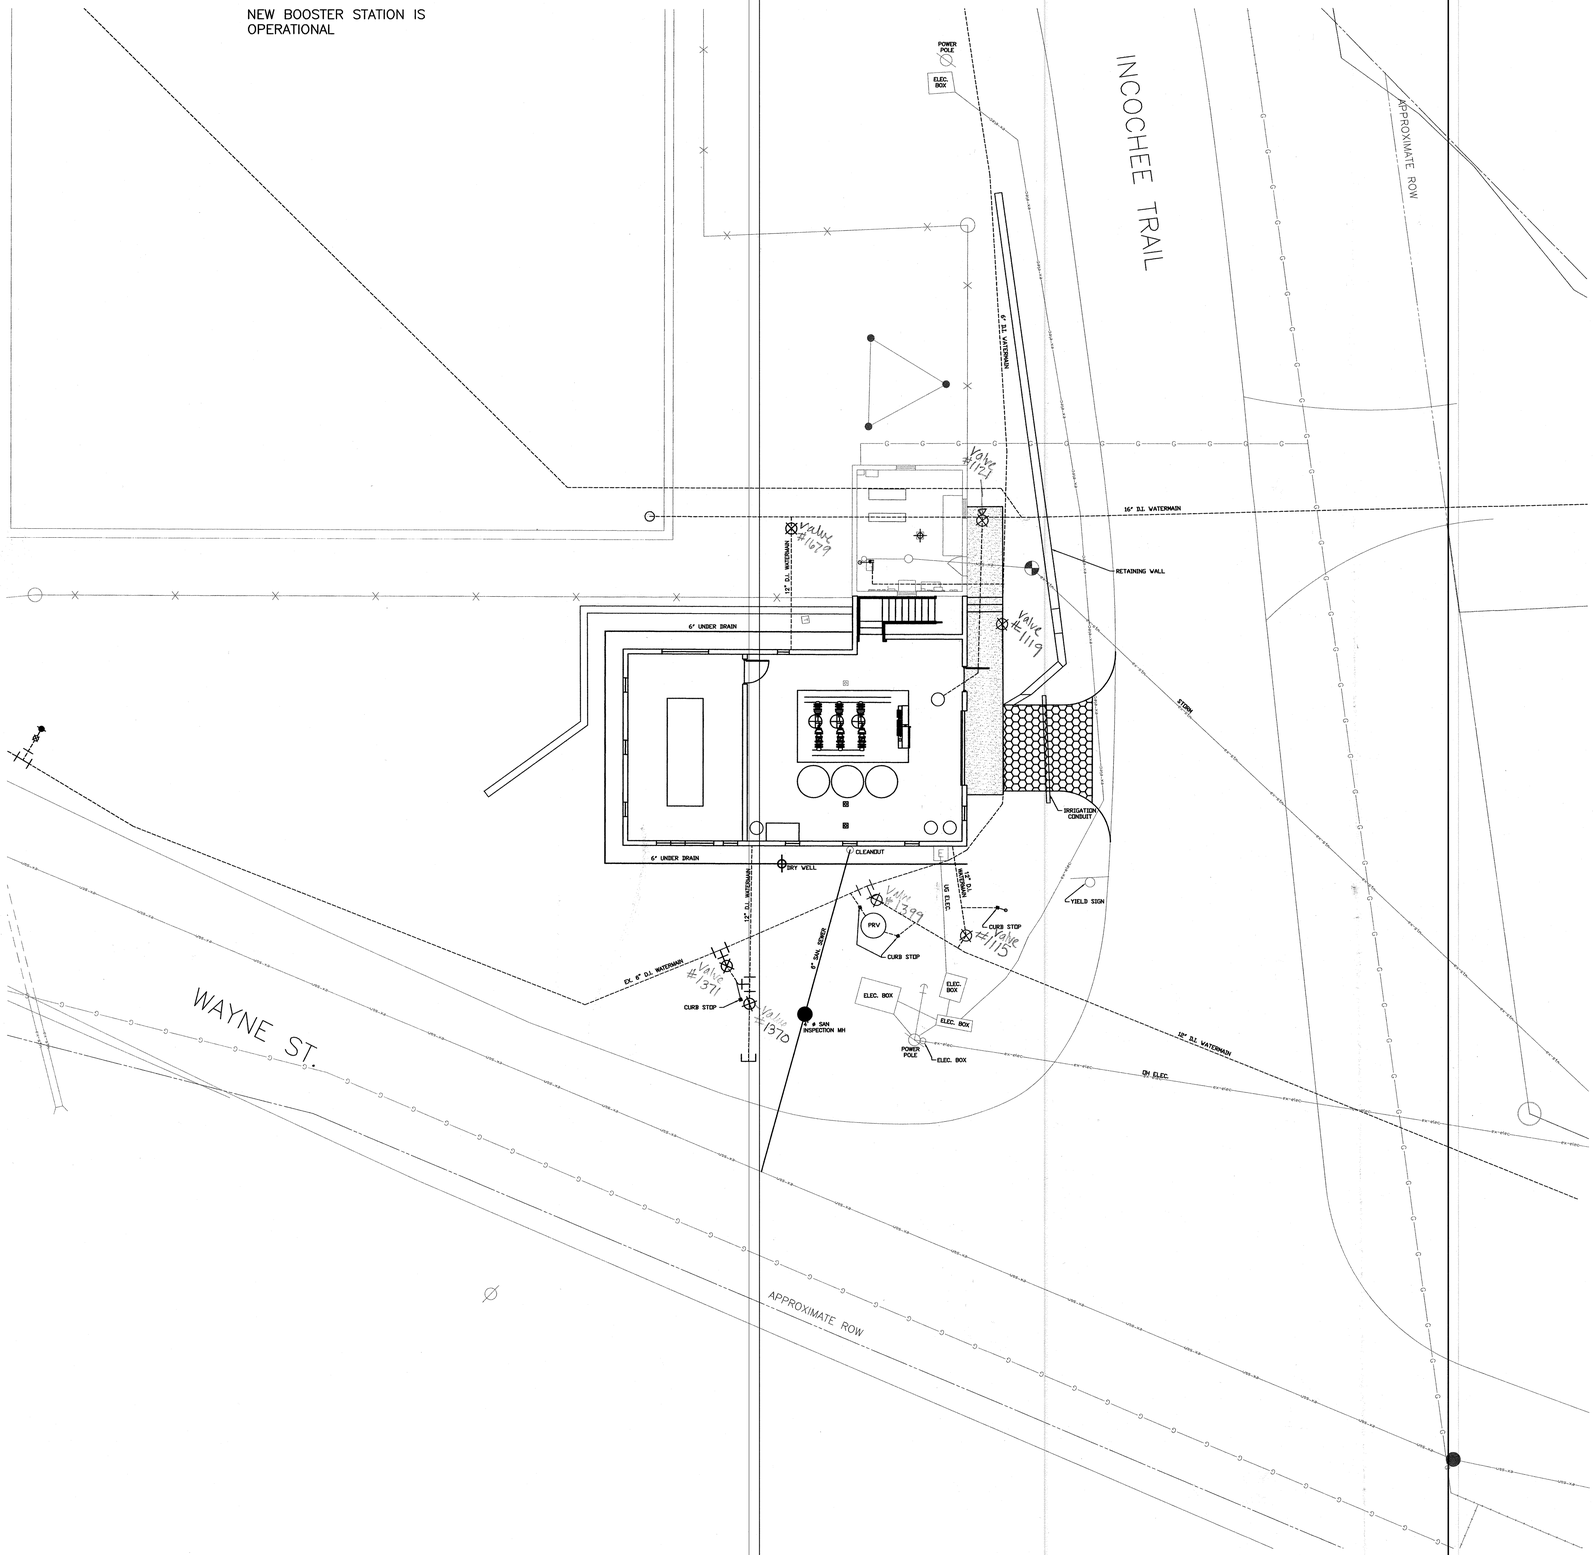

SCALE: 1"= 10'

- FOUND PROPERTY CORNER
- BENCHMARK
- SIGN
- GAS BOX
- UTILITY POLE
- GUY WIRE
- WATER VALVE
- PED LIGHT POLE
- ELECTRIC RISER
- TELEPHONE RISER/BOX
- FIRE HYDRANT ASSEMBLY
- CATCHBASIN
- BEEHIVE GRATE CATCHBASIN
- STORM MANHOLE
- SANITARY MANHOLE
- DECIDUOUS TREE
- CONIFEROUS TREE
- TREE LINE
- EXISTING FENCE
- PROPOSED SANITARY SEWER
- PROPOSED BITUMINOUS PAVED DRIVE
- PROPOSED CONCRETE APRON, SIDEWALK AND STEPS
- PROPOSED WATER VALVE
- PROPOSED DRYWELL

The City of Traverse City
Engineering Department
GOVERNMENTAL CENTER
400 Boardman Avenue
Traverse City, Michigan 49684

CITY OF TRAVERSE CITY
WAYNE HILL BOOSTER PUMP STATION
AS-BUILT SHEET

Revision/Issue	Date

Date: 09-12-06
Project No.: 03-011
Drawn by: JDM
Scale: 1" = 30'
Sheet No.: 1 OF 1